

M/043/019

Mountain Valley Stone, Inc.

Robert John Hicken
Tel: (435) 654-0120
Fax: (435) 654-3337

2276 South Daniels Road
Heber City, UT 84032
robert@mountainvalleystone.com

June 4, 2004

Lynn Kunzler
Utah Division of Oil, Gas and Mining
1594 West North Temple, Suite 1210
Salt Lake City, UT 84114-5801

RE: Notification of Scale House on Mountain Valley Stone's Brown Canyon Quarry


Dear Lynn:

Please be advised that Mountain Valley Stone has agreed to a contract with Ames Construction that entitles Ames Construction to haul clay from our quarry. The contract spans from June 1, 2004 through June 10, 2004. The clay will be taken from the south-east corner of our 5 year mine area. All clay that will be removed will be within our area of disturbance. For the purpose of more efficient access Ames has built a temporary road that enters on the east corner of the mine parcel, extends along the east property line and loops back to the existing road. Under the contract Ames has agreed to reclaim the disturbed area on or before June 30, 2004.

Please see Mountain Valley Stone Surface Facilities Map and our contract with Ames Construction for additional information.

Should you have any questions, please give me a call.

Sincerely,

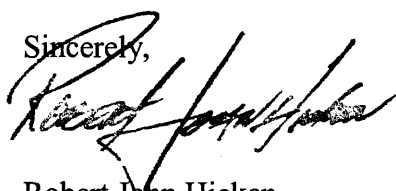

Robert John Hicken
President, Mountain Valley Stone, Inc.

Attached: Mountain Valley Stone Surface Facilities Map
Ames Construction Contract

RECEIVED

JUN 08 2004

DIV. OF OIL, GAS & MINING
0005

✓

Mountain Valley Stone, Inc.

Robert John Hicken
Tel: (435) 654-0120
Fax: (435) 654-3337

2276 South Daniels Road
Heber City, UT 84032
robert@mountainvalleystone.com

June 4, 2004

Lynn Kunzler
Utah Division of Oil, Gas and Mining
1594 West North Temple, Suite 1210
Salt Lake City, UT 84114-5801

RE: Notification of Scale House on Mountain Valley Stone's Brown Canyon Quarry

Dear Lynn:

Please be advised that Mountain Valley Stone has built a scale house on our quarry in Browns Canyon. The scale house is 12'x 12' and sits on a 20'x 20' concrete platform. The scale itself runs parallel to the scale house on the east side and is 20'x 90'. The scale house sits within our 5 year mine area. This addition to our quarry can be seen on the attached Mountain Valley Stone Surface Facilities Map.

Should you have any questions, please give me a call.

Sincerely,



Robert John Hicken
President, Mountain Valley Stone, Inc.

Attached: Mountain Valley Stone Surface Facilities Map

12

AGREEMENT

Agreement between Ames and Mountain Valley Stone, Inc. (MVS)

Ames hereby agrees to remove approximately 10,000 to 15,000 tons of clay material from the MVS quarry in Browns Canyon. This material is to be taken first from the lower quarry area with any remaining clay to be taken from the south east toe of the quarry. If the material in the lower quarry is not taken first, Ames will survey the existing material and prepay with in the terms of this agreement.

Ames will enter from the south east property line by removing the needed amount of fence and grubbing a simple road to entry. Upon completion and with in 30 days. Ames will reclaim, reinstall fences, and reseed the disturbed areas. The additional access fee will be \$500.00.

The clay will be weighed on a Fairbanks certified weight scale. Ames agrees to pay MVS \$1.25/ton for the clay material removed. The removed clay material will be billed by MVS to Ames on a weekly basis and will be due on net 10 day terms.

Ames will assume all responsibility for erosion control and sloping requirements imposed by the land owner and/or the State of Utah Department of Oil, Gas & Mining reclamation plan, permitting, fees, and access issues.

Ames will provide MVS with a certificate of general liability insurance and required contracting license before work begins.

Ames, by _____ (print name)

Date


Mountain Valley Stone, by Robert John Hicken

Date


12

MOUNTAIN VALLEY STONE SURFACE FACILITIES MAP

RECEIVED
6/11/2003
APPROVED
DATE 6/11/2003
BY: OIL, GAS & MINING

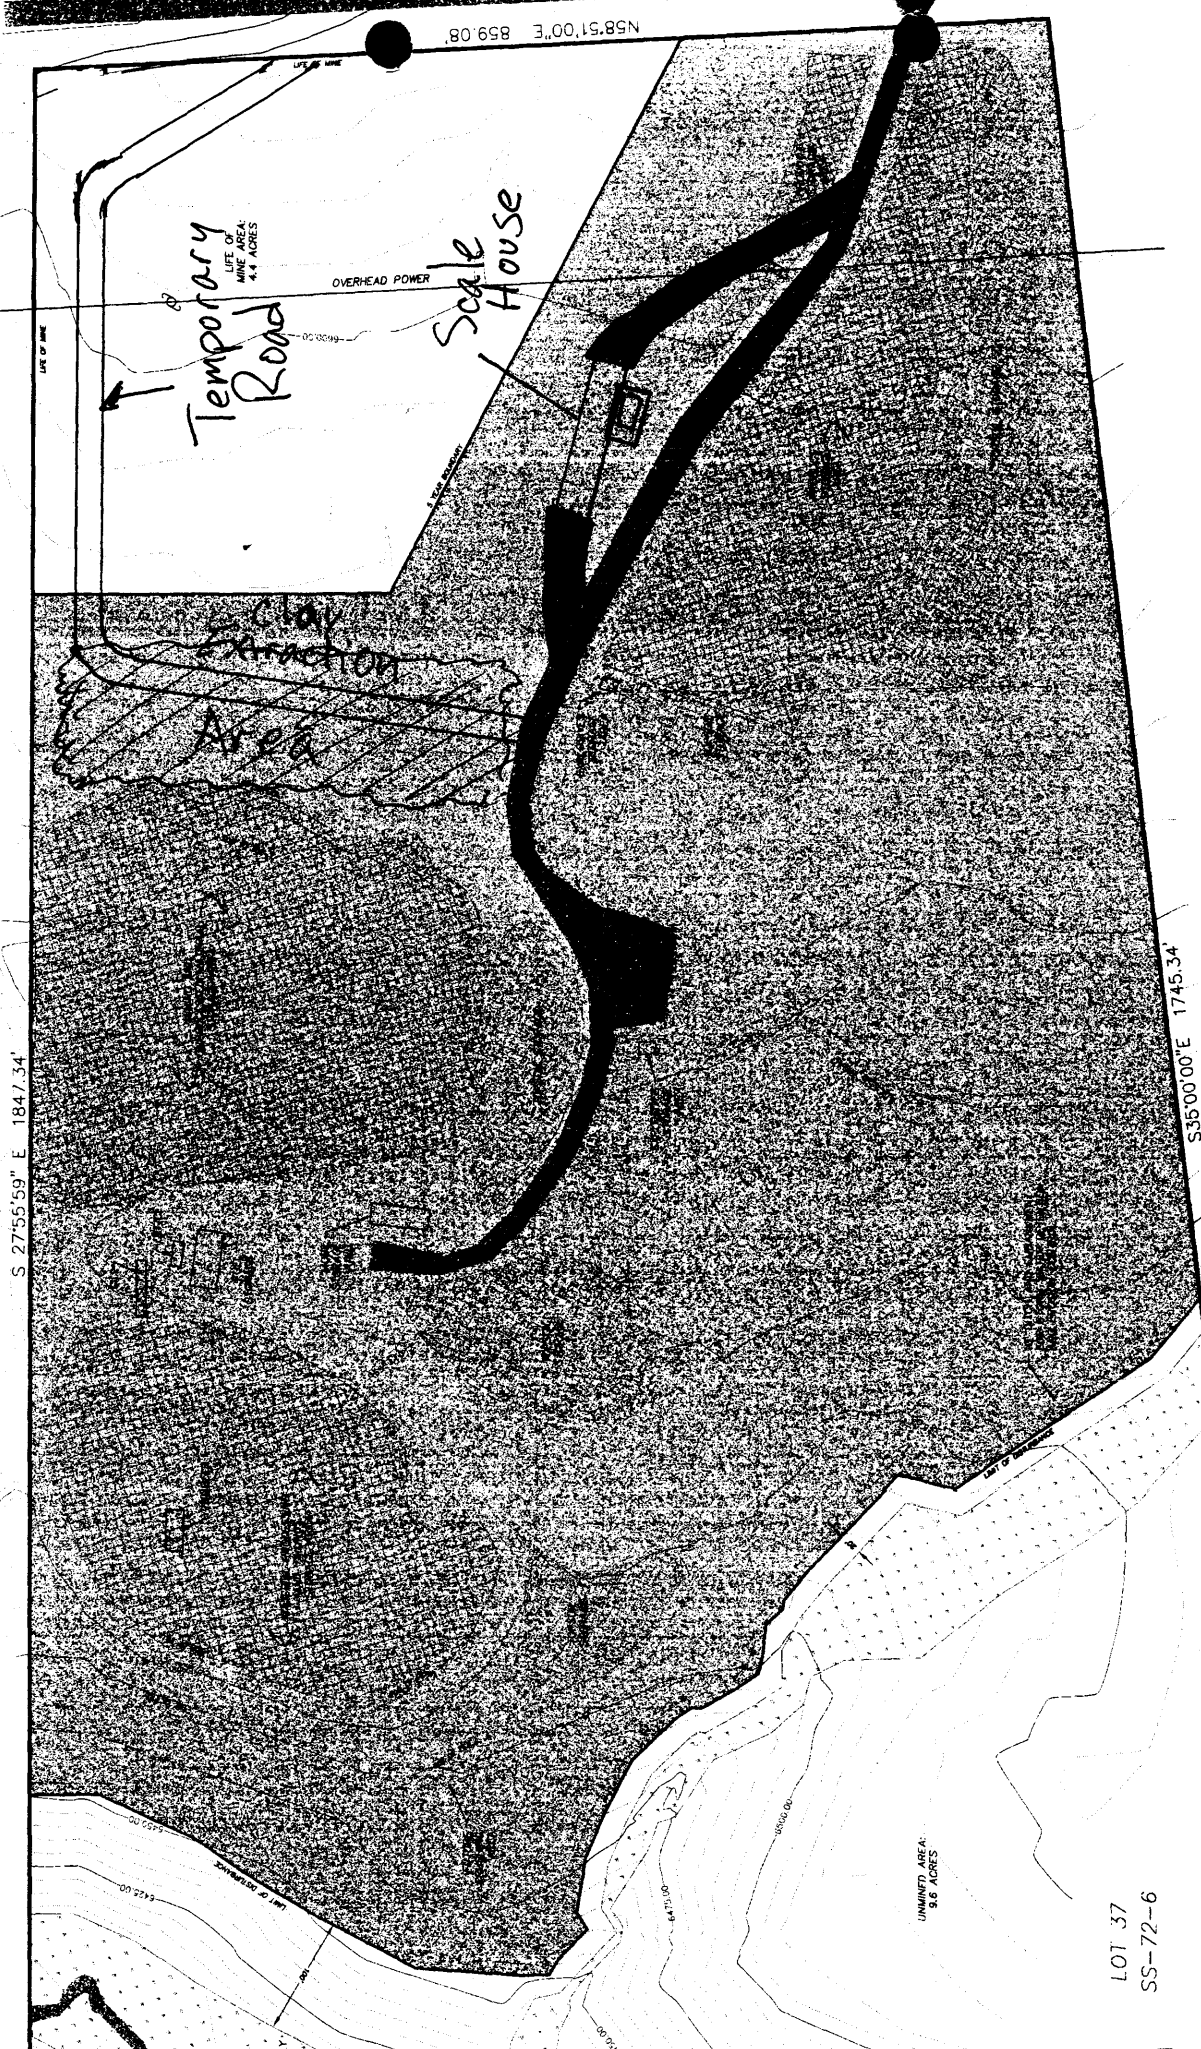

AREA TABULATIONS	
TOTAL PARCEL ACREAGE	40 ACRES
TOTAL LIFE OF MINE AREA	30.4 ACRES
5 YEAR MINE AREA	26 ACRES
UNMINED AREA	9.6 ACRES
AREA OF CURRENT DISTURBANCE	11.5 ACRES

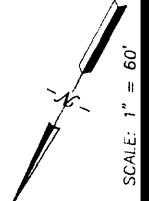

SCALE: 1" = 60'

LOT 37
SS-72-6

UNMINED AREA:
9.6 ACRES